LOWER LEVEL - SMOKE COMPARTMENTS

COMPARTMENT ID	COMPARTMENT SQ. FT.	AREA USE	MAXIMUM DISTANCE TO SMOKE BARRIER (FT)	MAXIMUM DISTANCE TO EXIT (FT)
LLA	6,866	HEALTHCARE	157	88
LLB	2,085	HEALTHCARE	141	86
TOTAL:	8,951			

LOWER LEVEL - SUITE INFORMATION

SUITE ID	SUITE SQ.FT.	SUITE TYPE	TRAVEL DISTANCE TO BOUNDARY (FT)
SL.1	5,184	NON-PATIENT	85

1 LOWER LEVEL
- LS-001 3/32"=1'-0"

LIFE SAFETY LEGEND

- 2FS — 2-HOUR FIRE/SMOKE BARRIER 90 MIN. OPENING PROTECTIVE
- 2FB — 2-HOUR FIRE BARRIER 90 MIN. OPENING PROTECTIVE
- 1FS — 1-HOUR FIRE/SMOKE BARRIER 45 MIN. OPENING PROTECTIVE*
- 1FB — 1-HOUR FIRE BARRIER 45 MIN. OPENING PROTECTIVE*
- 1SB — 1-HOUR SMOKE BARRIER SOLID CORE WOOD DOOR
- ST — BARRIER TO LIMIT THE TRANSFER OF SMOKE
- STE — SUITE BOUNDARY FOR ADJACENT SUITES
- S# — NON-SLEEPING SUITE
- S# — SLEEPING SUITE
- S# — NON-PATIENT SUITE
- HZ — HAZARDOUS AREA
- SHAFT — VERTICAL SHAFT
- EXIT OR EXIT DISCHARGE
- DENOTES DRY CHEMICAL EXTINGUISHER (BC TYPE)
- DENOTES DRY CHEMICAL EXTINGUISHER (ABC TYPE)
- DENOTES ILLUMINATED EXIT SIGN - SINGLE FACE, CEILING MOUNTED
- DENOTES ILLUMINATED EXIT SIGN - DOUBLE FACE, CEILING MOUNTED
- DENOTES FIRE-SMOKE DAMPER
- DENOTES SMOKE DAMPER
- DENOTES FIRE DAMPER

*60 MINUTE OPENING PROTECTIVE AT EXIT ENCLOSURE

GENERAL NOTES

1. BUILDING IS AN EXISTING HEALTHCARE OCCUPANCY PER CHAPTER 19 OF NFPA 101.
2. BUILDING IS EQUIPPED WITH AN AUTOMATIC SPRINKLER SYSTEM THROUGHOUT.
3. BUILDING IS EQUIPPED WITH AN AUTOMATIC FIRE ALARM SYSTEM THROUGHOUT.
4. DRAWINGS ARE FOR INFORMATION PURPOSES ONLY. THEY ARE NOT DESIGN DOCUMENTS OR INTENDED TO REFLECT AS-BUILT CONDITIONS.
5. DEVICE LOCATION IS BY OBSERVATION ONLY AND IS GENERAL IN NATURE. DEVICES THAT ARE CONCEALED OR NOT VIEWABLE USING A 6-FOOT LADDER MAY NOT BE INCLUDED.

KEY NOTES

1. DOORS ARE EQUIPPED WITH ACCESS CONTROL DEVICE

JENSEN HUGHES
Advancing the Science of Safety
2301 West Plano Pkwy
Suite 210
Plano, TX 75075-8402
O: 469-443-7200 | F: 469-443-7201
www.jensenhughes.com

NO.	REVISION	DATE

KEY PLAN

SEAL

IT IS A VIOLATION OF STATE LAW FOR ANY PERSON, UNLESS ACTING UNDER THE DIRECTION OF A LICENSED ENGINEER, TO ALTER THIS DRAWING IN ANY WAY. IF AN ITEM IS ALTERED, THE ALTERING ENGINEER SHALL AFFIX TO THE ITEM HIS/HER SEAL AND THE NOTATION "ALTERED BY" FOLLOWED BY HIS/HER SIGNATURE AND THE DATE OF SUCH ALTERATION, AND A SPECIFIC DESCRIPTION OF THE ALTERATION.

PROJECT
JPS Patient Care Pavilion

ADDRESS
1575 South Main St.
Fort Worth, TX 76014

PROJECT NO 1MRG20017.00

DATE April 2, 2021

DESIGN	DRAWN BY	CHECKED BY
TME	VALUE	MRG

SCALE
SCALE AS NOTED

TITLE

LOWER LEVEL
VALUE

NUMBER
LS-001

SHEET VALUE OF 15

REVDATE: - FILE NAME: Y:\Drawn\Loppy\US\VMD\Proj\1--GBWAR\1MRG20017.000 - JPS Fire and Life Safety (JPS)\5.0 Fire and Life Safety Drawings\2.0 Main Campus\Life Safety\JPS Pavilion Life Safety.dwg LAYOUT NAME: LS-001 PLOTTED: Tuesday, March 30, 2021 - 10:41am

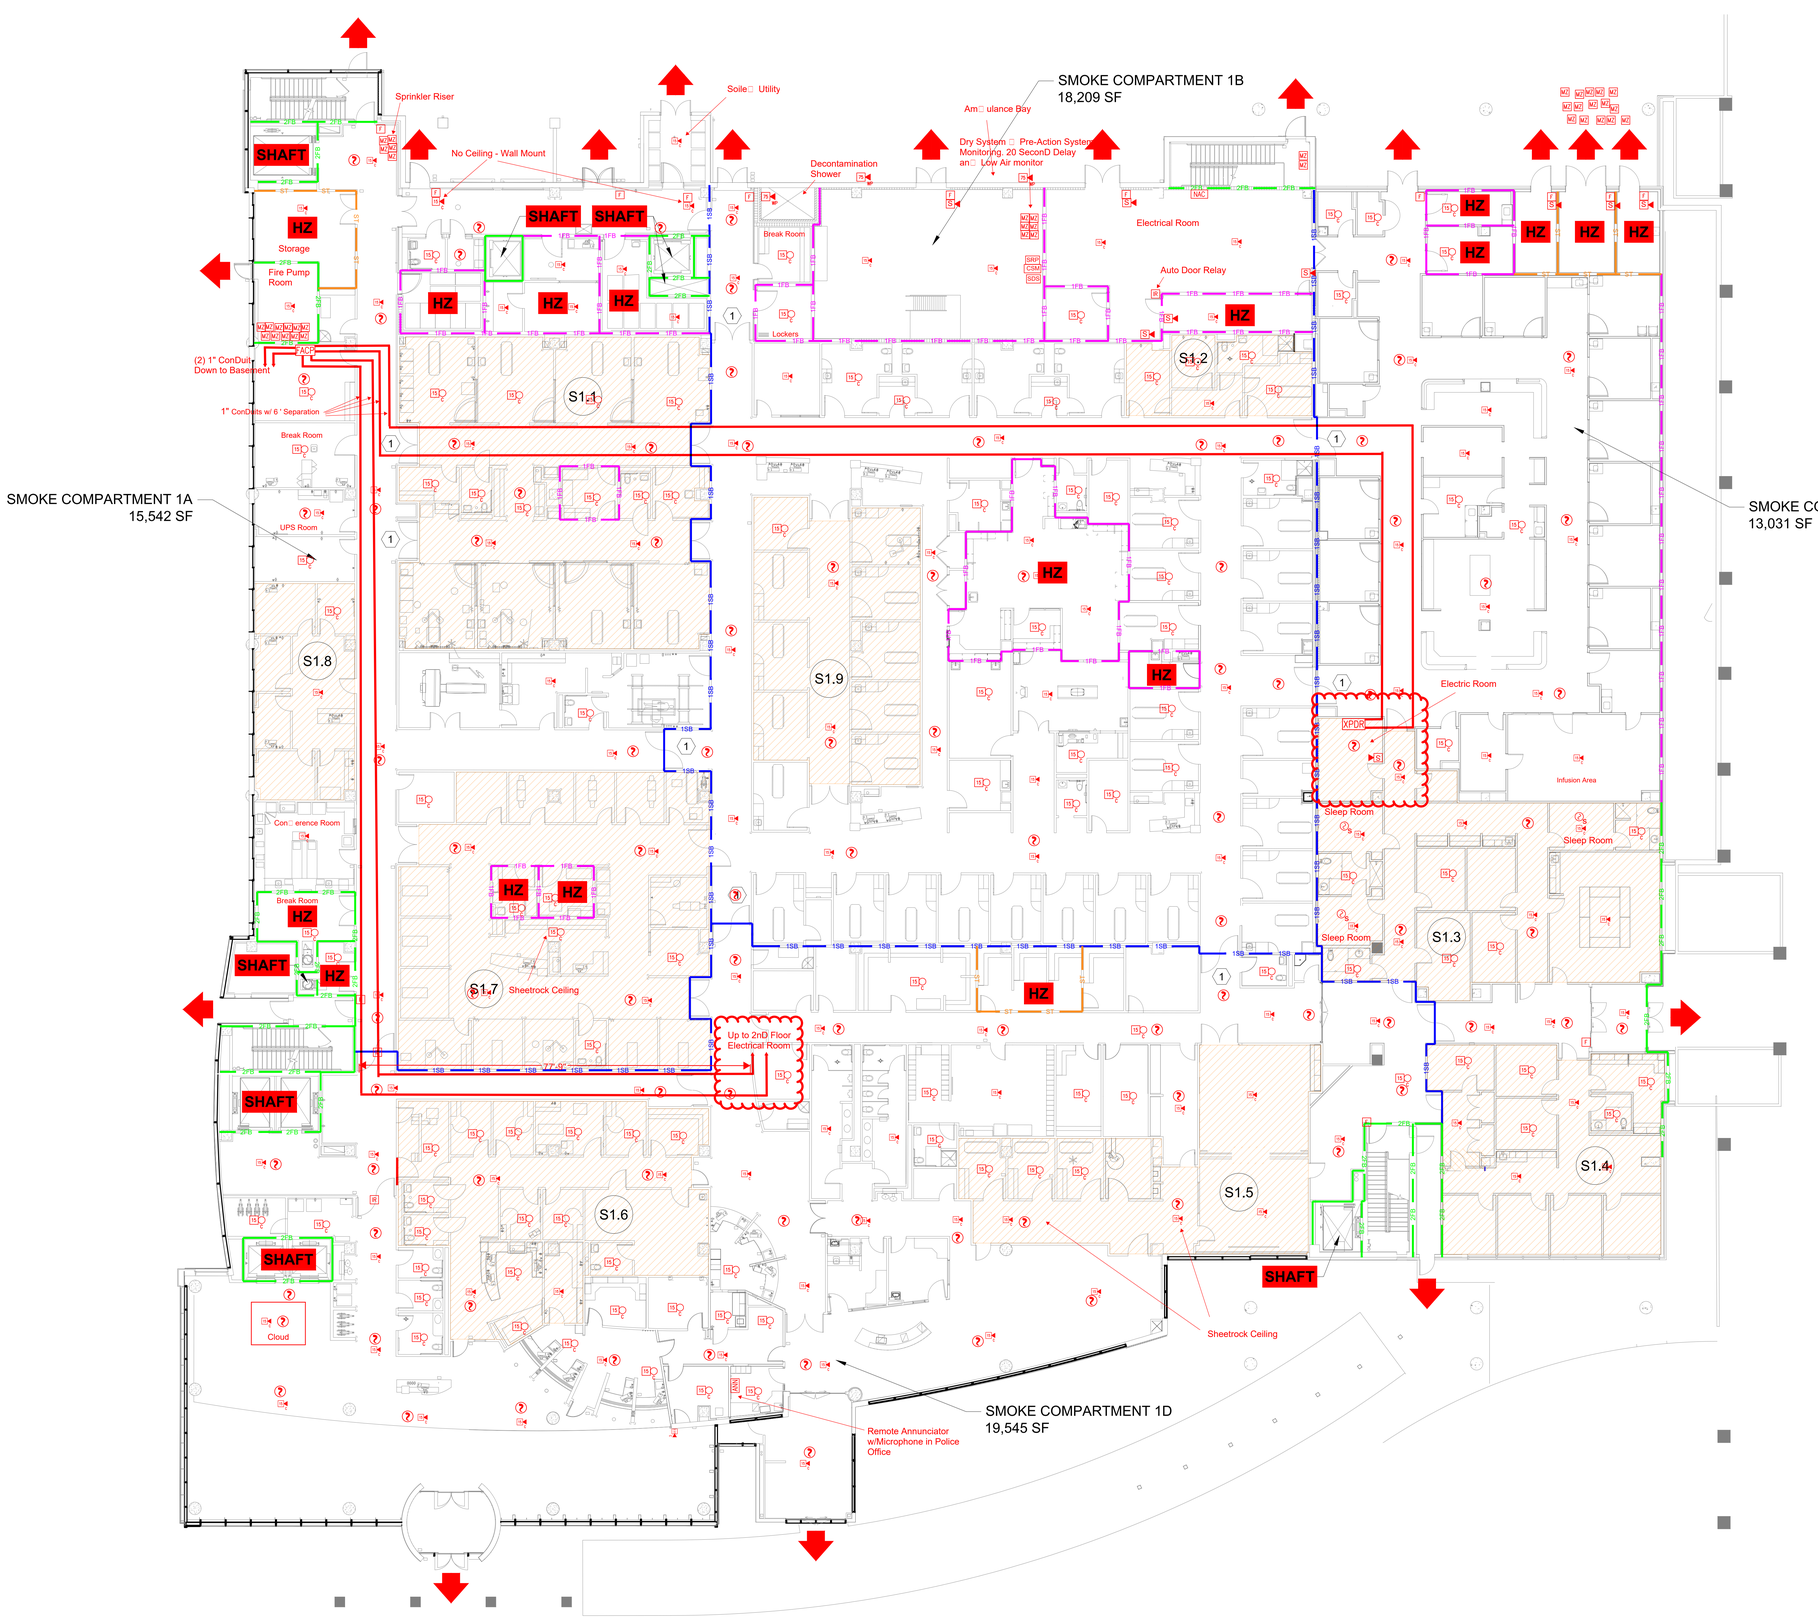

1 **LEVEL 1**
- | LS-002 3/32"=1'-0"

LIFE SAFETY LEGEND

- 2FS — 2-HOUR FIRE/SMOKE BARRIER 90 MIN. OPENING PROTECTIVE
- 2FB — 2-HOUR FIRE BARRIER 90 MIN. OPENING PROTECTIVE
- 1FS — 1-HOUR FIRE/SMOKE BARRIER 45 MIN. OPENING PROTECTIVE*
- 1FB — 1-HOUR FIRE BARRIER 45 MIN. OPENING PROTECTIVE*
- 1SB — 1-HOUR SMOKE BARRIER SOLID CORE WOOD DOOR
- ST — BARRIER TO LIMIT THE TRANSFER OF SMOKE
- STE — SUITE BOUNDARY FOR ADJACENT SUITES
- S# — NON-SLEEPING SUITE
- S# — SLEEPING SUITE
- S# — NON-PATIENT SUITE
- HZ — HAZARDOUS AREA
- SHAFT — VERTICAL SHAFT
- EXIT OR EXIT DISCHARGE
- DENOTES DRY CHEMICAL EXTINGUISHER (BC TYPE)
- DENOTES DRY CHEMICAL EXTINGUISHER (ABC TYPE)
- DENOTES ILLUMINATED EXIT SIGN - SINGLE FACE, CEILING MOUNTED
- DENOTES ILLUMINATED EXIT SIGN - DOUBLE FACE, CEILING MOUNTED
- DENOTES FIRE-SMOKE DAMPER
- DENOTES SMOKE DAMPER
- DENOTES FIRE DAMPER

*60 MINUTE OPENING PROTECTIVE AT EXIT ENCLOSURE

GENERAL NOTES

1. BUILDING IS AN EXISTING HEALTHCARE OCCUPANCY PER CHAPTER 19 OF NFPA 101.
2. BUILDING IS EQUIPPED WITH AN AUTOMATIC SPRINKLER SYSTEM THROUGHOUT.
3. BUILDING IS EQUIPPED WITH AN AUTOMATIC FIRE ALARM SYSTEM THROUGHOUT.
4. DRAWINGS ARE FOR INFORMATION PURPOSES ONLY. THEY ARE NOT DESIGN DOCUMENTS OR INTENDED TO REFLECT AS-BUILT CONDITIONS.
5. DEVICE LOCATION IS BY OBSERVATION ONLY AND IS GENERAL IN NATURE. DEVICES THAT ARE CONCEALED OR NOT VIEWABLE USING A 6-FOOT LADDER MAY NOT BE INCLUDED.

KEY NOTES

1 DOORS ARE EQUIPPED WITH ACCESS CONTROL DEVICE

LEVEL 1 - SMOKE COMPARTMENTS

COMPARTMENT ID	COMPARTMENT SQ. FT.	AREA USE	MAXIMUM DISTANCE TO SMOKE BARRIER (FT)	MAXIMUM DISTANCE TO EXIT (FT)
1A	15,542	HEALTHCARE	114	162
1B	4,480	HEALTHCARE	116	183
1C	20,022	HEALTHCARE	109	151
1D	19,545	HEALTHCARE	125	174
TOTAL:	59,589			

LEVEL 1 - SUITE INFORMATION

SUITE ID	SUITE SQ.FT.	SUITE TYPE	TRAVEL DISTANCE TO BOUNDARY (FT)
S1.1	3,637	NON-SLEEPING	41
S1.2	551	NON-SLEEPING	25
S1.3	2,789	NON-SLEEPING	57
S1.4	1,790	NON-SLEEPING	54
S1.5	1,884	NON-SLEEPING	30
S1.6	2,329	NON-SLEEPING	50
S1.7	3,332	NON-SLEEPING	61
S1.8	834	NON-SLEEPING	39
S1.9	1,647	NON-SLEEPING	43

JENSEN HUGHES
Advancing the Science of Safety
2301 West Plano Pkwy
Suite 210
Plano, TX 75075-8402
O: 469-443-7200 | F: 469-443-7201
www.jensenhughes.com

NO.	REVISION	DATE

KEY PLAN

SEAL

IT IS A VIOLATION OF STATE LAW FOR ANY PERSON, UNLESS ACTING UNDER THE DIRECTION OF A LICENSED ENGINEER, TO ALTER THIS DRAWING IN ANY WAY. IF AN ITEM IS ALTERED, THE ALTERING ENGINEER SHALL AFFIX TO THE ITEM HIS/HER SEAL AND THE NOTATION "ALTERED BY" FOLLOWED BY HIS/HER SIGNATURE AND THE DATE OF SUCH ALTERATION, AND A SPECIFIC DESCRIPTION OF THE ALTERATION.

PROJECT
JPS Patient Care Pavilion

ADDRESS
1575 South Main St.
Fort Worth, TX 76014

PROJECT NO 1MRG20017.00

DATE April 2, 2021

DESIGN	DRAWN BY	CHECKED BY
TME	VALUE	MRG

SCALE
SCALE AS NOTED

TITLE

LEVEL 1
VALUE

NUMBER
LS-002

SHEET VALUE OF 15

REVDATE: - FILE NAME: Y:\Shared\Legacy\GVA\GVA\Proj\1--GENHAM\1MRG20017.000 - JPS Fire and Life Safety (JPS)\5.0 pr Life Safety Drawings\2.0 Main Campus\12x Safety\JPS Pavilion Life Safety.dwg LAYOUT NAME: LS-002 PLOTTED: Tuesday, March 30, 2021 - 10:47am

LEVEL 2 - SMOKE COMPARTMENTS

COMPARTMENT ID	COMPARTMENT SQ. FT.	AREA USE	MAXIMUM DISTANCE TO SMOKE BARRIER (FT)	MAXIMUM DISTANCE TO EXIT (FT)
2A	7,226	HEALTHCARE	78	117
2B	21,661	HEALTHCARE	120	198
2C	12,018	HEALTHCARE	114	186
2D	14,632	HEALTHCARE	121	166
2E	9,342	HEALTHCARE	67	171
2F	5,088	HEALTHCARE	104	134
TOTAL:	69,967			

LEVEL 2 - SUITE INFORMATION

SUITE ID	SUITE SQ.FT.	SUITE TYPE	TRAVEL DISTANCE TO BOUNDARY (FT)
S2.1	4,416	NON-SLEEPING	70
S2.2	8,856	NON-SLEEPING	74
S2.3	7,137	NON-SLEEPING	92

SMOKE COMPARTMENT 2A
7,226 SF

SMOKE COMPARTMENT 2B
21,661 SF

SMOKE COMPARTMENT 2C
12,018 SF

SMOKE COMPARTMENT 2D
14,632 SF

SMOKE COMPARTMENT 2E
9,342 SF

SMOKE COMPARTMENT 2F
5,088 SF

S2.1 S2.2 S2.3

Elec Room
Break Room
Break Room
Elec Room
Riser up to 3rd Floor w/ F Separation
77'-9"
105'-5 1/4"

1 LEVEL 2
- LS-003 3/32"=1'-0"

LIFE SAFETY LEGEND

- 2FS — 2-HOUR FIRE/SMOKE BARRIER 90 MIN. OPENING PROTECTIVE
- 2FB — 2-HOUR FIRE BARRIER 90 MIN. OPENING PROTECTIVE
- 1FS — 1-HOUR FIRE/SMOKE BARRIER 45 MIN. OPENING PROTECTIVE*
- 1FB — 1-HOUR FIRE BARRIER 45 MIN. OPENING PROTECTIVE*
- 1SB — 1-HOUR SMOKE BARRIER SOLID CORE WOOD DOOR
- ST — BARRIER TO LIMIT THE TRANSFER OF SMOKE
- STE — SUITE BOUNDARY FOR ADJACENT SUITES
- S# # — NON-SLEEPING SUITE
- S# # — SLEEPING SUITE
- S# # — NON-PATIENT SUITE
- HZ — HAZARDOUS AREA
- SHAFT — VERTICAL SHAFT
- EXIT OR EXIT DISCHARGE
- DENOTES DRY CHEMICAL EXTINGUISHER (BC TYPE)
- DENOTES DRY CHEMICAL EXTINGUISHER (ABC TYPE)
- DENOTES ILLUMINATED EXIT SIGN - SINGLE FACE, CEILING MOUNTED
- DENOTES ILLUMINATED EXIT SIGN - DOUBLE FACE, CEILING MOUNTED
- DENOTES FIRE-SMOKE DAMPER
- DENOTES SMOKE DAMPER
- DENOTES FIRE DAMPER

*60 MINUTE OPENING PROTECTIVE AT EXIT ENCLOSURE

GENERAL NOTES

1. BUILDING IS AN EXISTING HEALTHCARE OCCUPANCY PER CHAPTER 19 OF NFPA 101.
2. BUILDING IS EQUIPPED WITH AN AUTOMATIC SPRINKLER SYSTEM THROUGHOUT.
3. BUILDING IS EQUIPPED WITH AN AUTOMATIC FIRE ALARM SYSTEM THROUGHOUT.
4. DRAWINGS ARE FOR INFORMATION PURPOSES ONLY. THEY ARE NOT DESIGN DOCUMENTS OR INTENDED TO REFLECT AS-BUILT CONDITIONS.
5. DEVICE LOCATION IS BY OBSERVATION ONLY AND IS GENERAL IN NATURE. DEVICES THAT ARE CONCEALED OR NOT VIEWABLE USING A 6-FOOT LADDER MAY NOT BE INCLUDED.

KEY NOTES

(1) DOORS ARE EQUIPPED WITH ACCESS CONTROL DEVICE

JENSEN HUGHES
Advancing the Science of Safety
2301 West Plano Pkwy, Suite 210
Plano, TX 75075-8402
O: 469-443-7200 | F: 469-443-7201
www.jensenhughes.com

NO.	REVISION	DATE

KEY PLAN

SEAL

IT IS A VIOLATION OF STATE LAW FOR ANY PERSON, UNLESS ACTING UNDER THE DIRECTION OF A LICENSED ENGINEER, TO ALTER THIS DRAWING IN ANY WAY. IF AN ITEM IS ALTERED, THE ALTERING ENGINEER SHALL AFFIX TO THE ITEM HIS/HER SEAL AND THE NOTATION "ALTERED BY" FOLLOWED BY HIS/HER SIGNATURE AND THE DATE OF SUCH ALTERATION, AND A SPECIFIC DESCRIPTION OF THE ALTERATION.

PROJECT
JPS Patient Care Pavilion

ADDRESS
1575 South Main St.
Fort Worth, TX 76014

PROJECT NO 1MRG20017.00

DATE April 2, 2021

DESIGN	DRAWN BY	CHECKED BY
TME	VALUE	MRG

SCALE
SCALE AS NOTED

TITLE

LEVEL 2
VALUE

NUMBER
LS-003

SHEET VALUE OF 15

REVDATE: - FILE NAME: N:\Shared\Legacy\US\FtW\Proj\1-1EBHWT\1MRG20017.000 - JPS Fire and Life Safety (JPS)\5.0 JH Life Safety Drawings\10 Main Campus\Life Safety\JPS Pavilion LSA Safety.dwg - LAYOUT NAME: LS-003 - PLOTTED: Tuesday, March 30, 2021 - 10:41am

LEVEL 3 - SMOKE COMPARTMENTS

COMPARTMENT ID	COMPARTMENT SQ. FT.	AREA USE	MAXIMUM DISTANCE TO SMOKE BARRIER (FT)	MAXIMUM DISTANCE TO EXIT (FT)
3A	13,722	HEALTHCARE	188	142
3B	7,458	HEALTHCARE	145	126
3C	8,403	HEALTHCARE	157	163
TOTAL:	29,583			

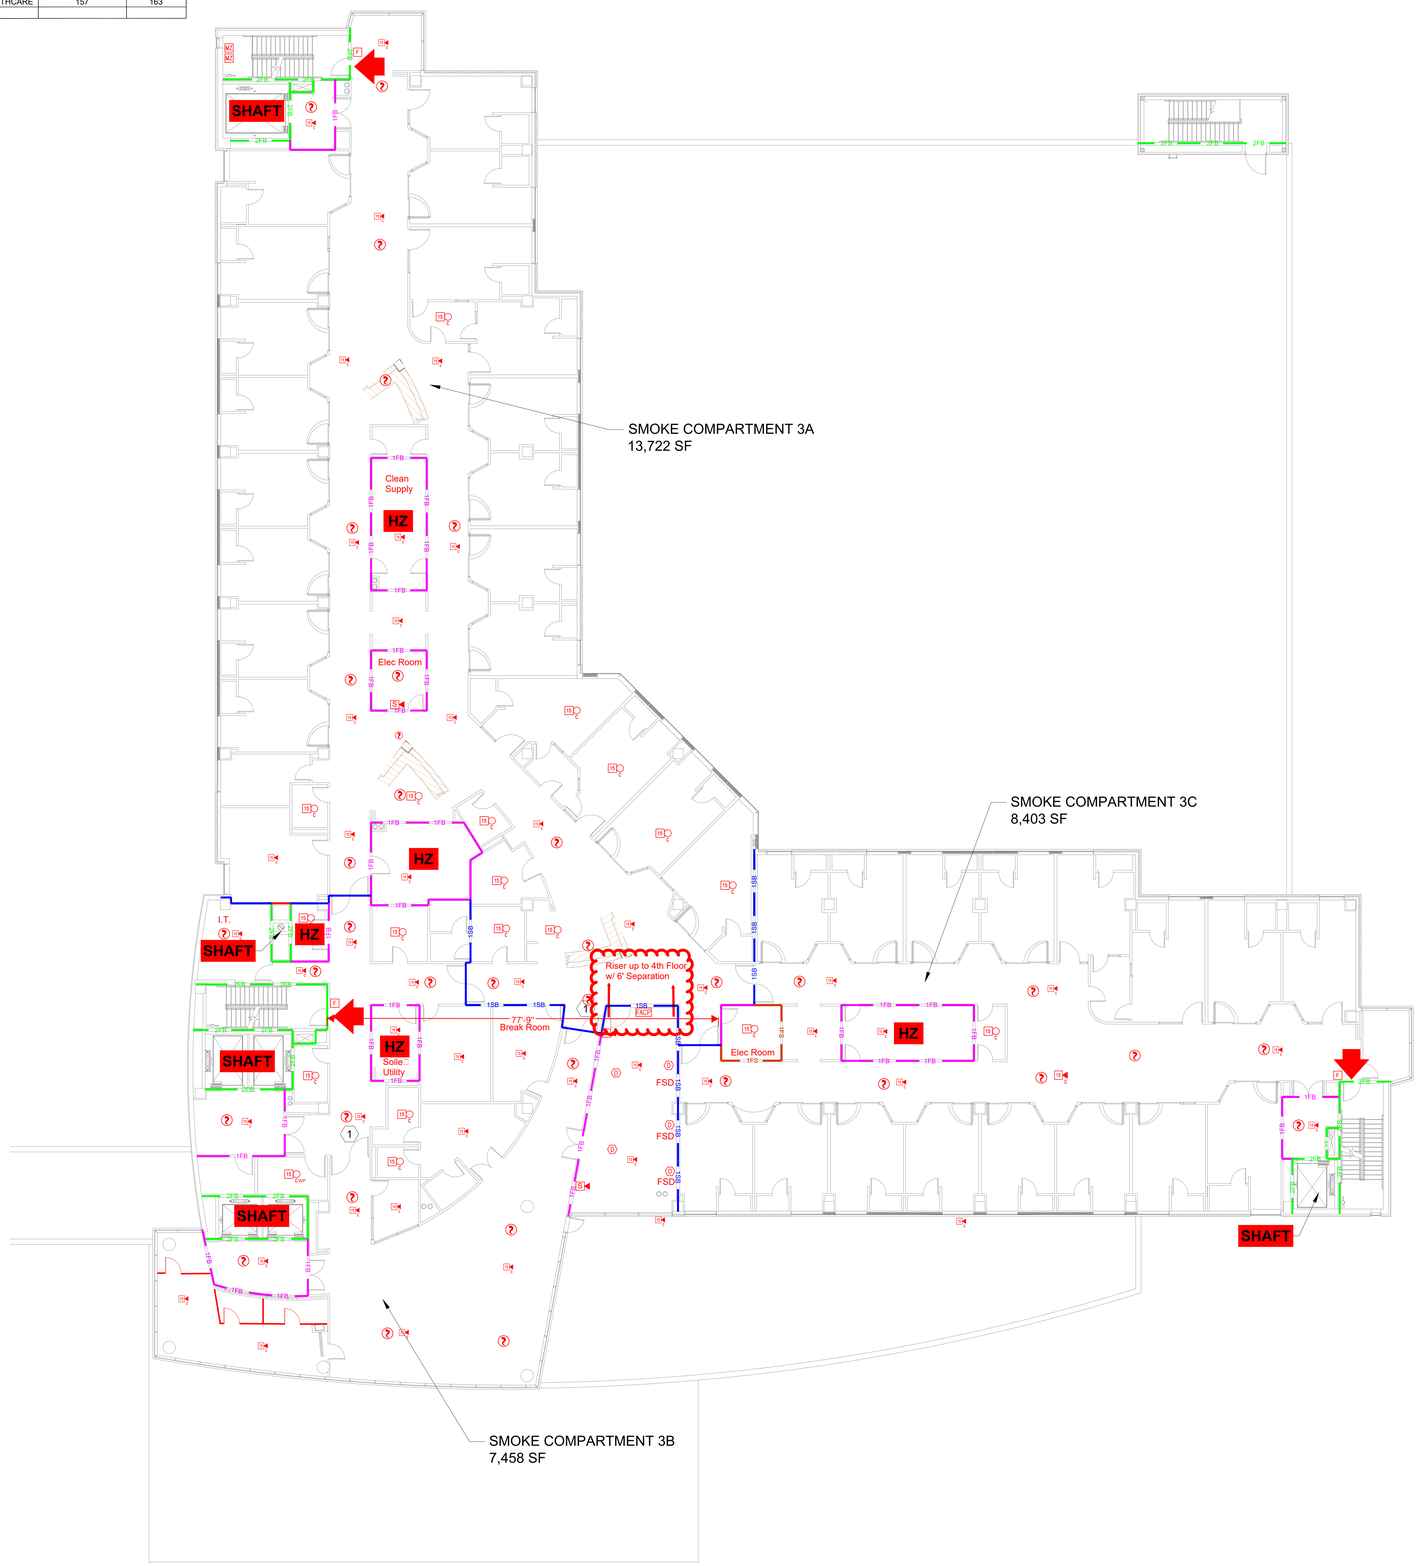

1 LEVEL 3
- LS-004 3/32"=1'-0"

LIFE SAFETY LEGEND

- 2FS — 2-HOUR FIRE/SMOKE BARRIER 90 MIN. OPENING PROTECTIVE
- 2FB — 2-HOUR FIRE BARRIER 90 MIN. OPENING PROTECTIVE
- 1FS — 1-HOUR FIRE/SMOKE BARRIER 45 MIN. OPENING PROTECTIVE*
- 1FB — 1-HOUR FIRE BARRIER 45 MIN. OPENING PROTECTIVE*
- 1SB — 1-HOUR SMOKE BARRIER SOLID CORE WOOD DOOR
- ST — BARRIER TO LIMIT THE TRANSFER OF SMOKE
- STE — SUITE BOUNDARY FOR ADJACENT SUITES
- S# # — NON-SLEEPING SUITE
- S# # — SLEEPING SUITE
- S# # — NON-PATIENT SUITE
- HZ — HAZARDOUS AREA
- SHAFT — VERTICAL SHAFT
- EXIT OR EXIT DISCHARGE
- DENOTES DRY CHEMICAL EXTINGUISHER (BC TYPE)
- DENOTES DRY CHEMICAL EXTINGUISHER (ABC TYPE)
- DENOTES ILLUMINATED EXIT SIGN - SINGLE FACE, CEILING MOUNTED
- DENOTES ILLUMINATED EXIT SIGN - DOUBLE FACE, CEILING MOUNTED
- DENOTES FIRE-SMOKE DAMPER
- DENOTES SMOKE DAMPER
- DENOTES FIRE DAMPER

*60 MINUTE OPENING PROTECTIVE AT EXIT ENCLOSURE

GENERAL NOTES

1. BUILDING IS AN EXISTING HEALTHCARE OCCUPANCY PER CHAPTER 19 OF NFPA 101.
2. BUILDING IS EQUIPPED WITH AN AUTOMATIC SPRINKLER SYSTEM THROUGHOUT.
3. BUILDING IS EQUIPPED WITH AN AUTOMATIC FIRE ALARM SYSTEM THROUGHOUT.
4. DRAWINGS ARE FOR INFORMATION PURPOSES ONLY. THEY ARE NOT DESIGN DOCUMENTS OR INTENDED TO REFLECT AS-BUILT CONDITIONS.
5. DEVICE LOCATION IS BY OBSERVATION ONLY AND IS GENERAL IN NATURE. DEVICES THAT ARE CONCEALED OR NOT VIEWABLE USING A 6-FOOT LADDER MAY NOT BE INCLUDED.

KEY NOTES

1. DOORS ARE EQUIPPED WITH ACCESS CONTROL DEVICE

JENSEN HUGHES
Advancing the Science of Safety
2301 West Plano Pkwy
Suite 210
Plano, TX 75075-8402
O: 469-443-7200 | F: 469-443-7201
www.jensenhughes.com

NO.	REVISION	DATE

KEY PLAN

SEAL

IT IS A VIOLATION OF STATE LAW FOR ANY PERSON, UNLESS ACTING UNDER THE DIRECTION OF A LICENSED ENGINEER, TO ALTER THIS DRAWING IN ANY WAY. IF AN ITEM IS ALTERED, THE ALTERING ENGINEER SHALL AFFIX TO THE ITEM HIS/HER SEAL AND THE NOTATION "ALTERED BY" FOLLOWED BY HIS/HER SIGNATURE AND THE DATE OF SUCH ALTERATION, AND A SPECIFIC DESCRIPTION OF THE ALTERATION.

PROJECT
JPS Patient Care Pavilion

ADDRESS
1575 South Main St.
Fort Worth, TX 76014

PROJECT NO
1MRG20017.00

DATE
April 2, 2021

DESIGN	DRAWN BY	CHECKED BY
TME	VALUE	MRG

SCALE
SCALE AS NOTED

TITLE

LEVEL 3
VALUE

NUMBER
LS-004

SHEET
VALUE OF 15

LEVEL 4 - SMOKE COMPARTMENTS

COMPARTMENT ID	COMPARTMENT SQ. FT.	AREA USE	MAXIMUM DISTANCE TO SMOKE BARRIER (FT)	MAXIMUM DISTANCE TO EXIT (FT)
4A	13,708	HEALTHCARE	188	142
4B	7,472	HEALTHCARE	123	110
4C	8,403	HEALTHCARE	157	163
TOTAL:	29,583			

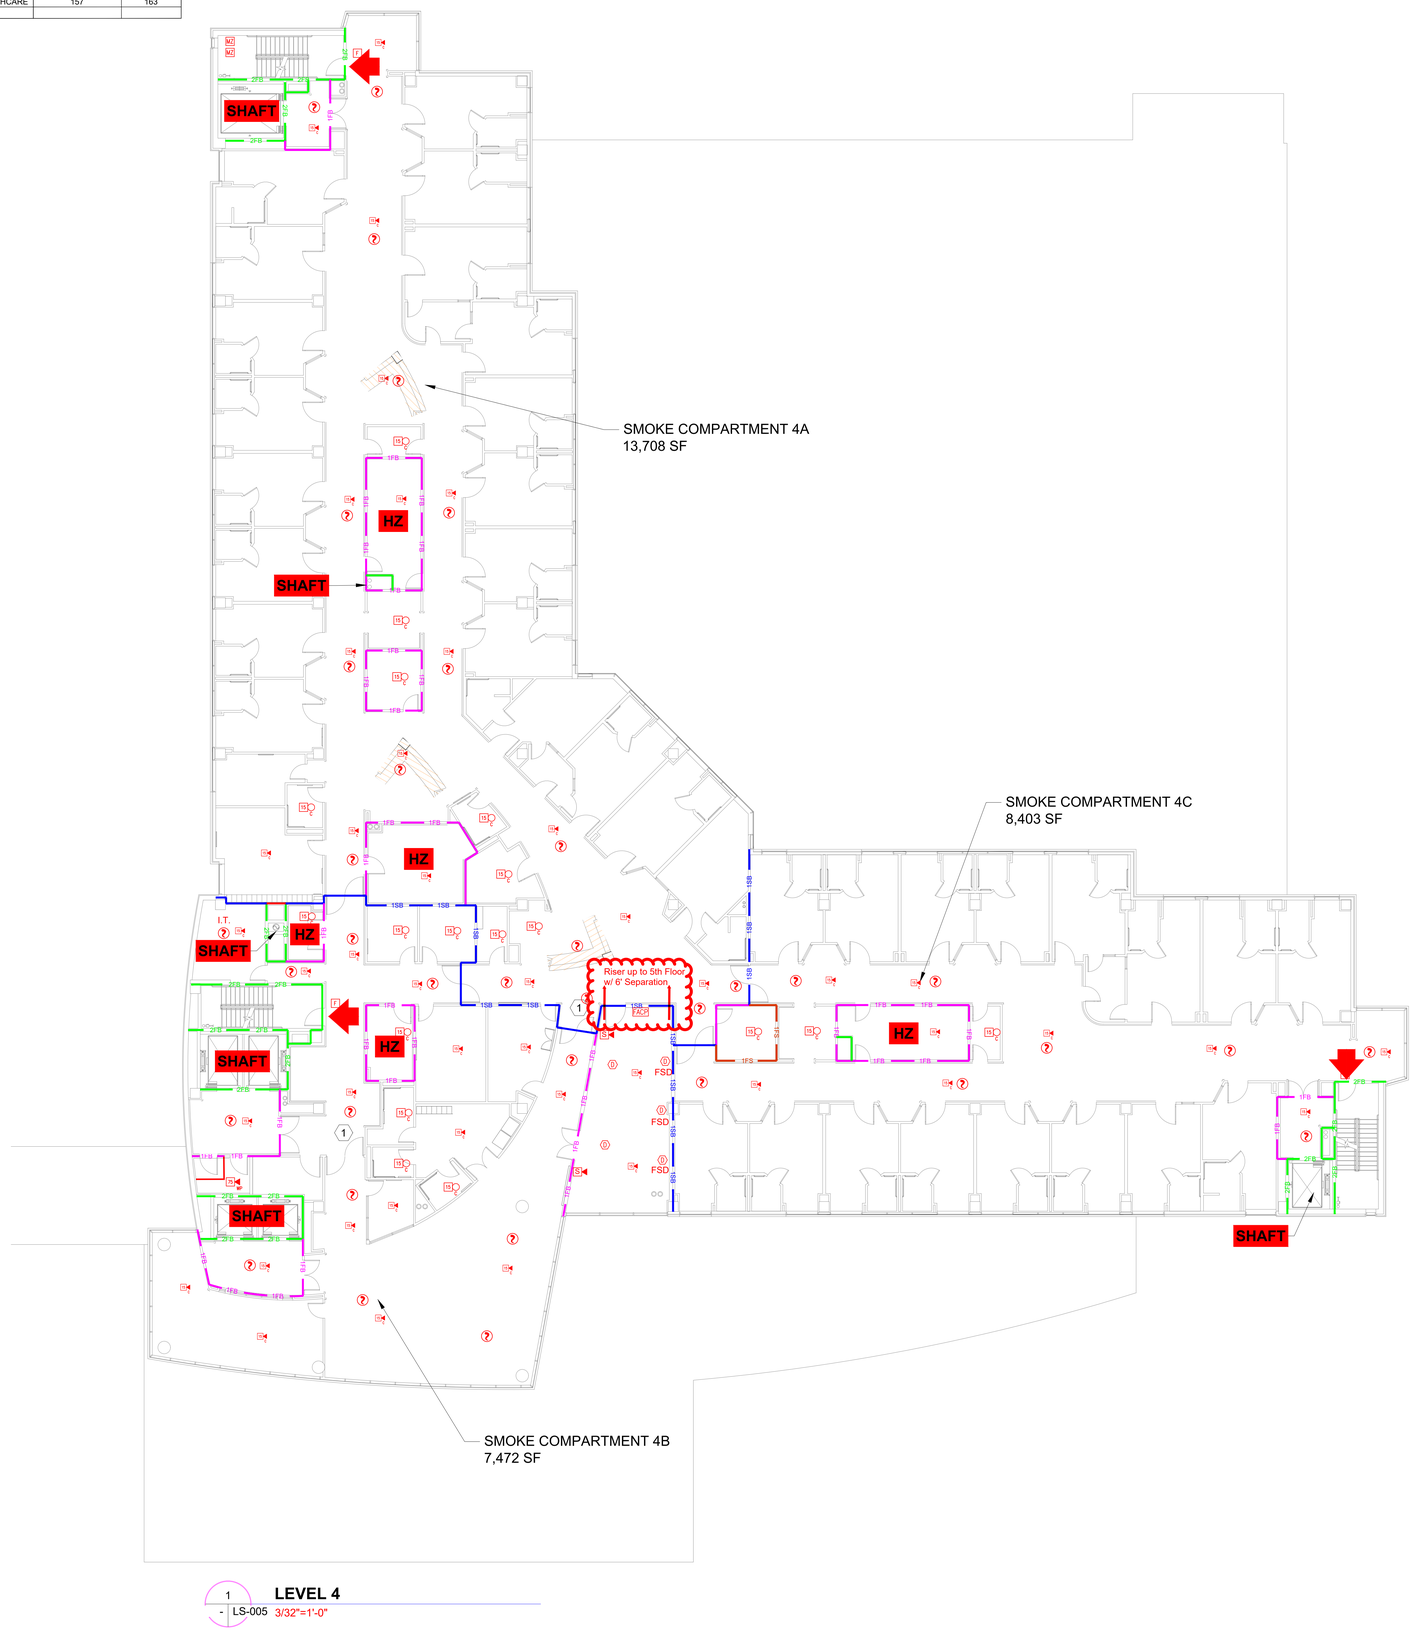

1 LEVEL 4
- LS-005 3/32"=1'-0"

LIFE SAFETY LEGEND

- 2FS — 2-HOUR FIRE/SMOKE BARRIER 90 MIN. OPENING PROTECTIVE
- 2FB — 2-HOUR FIRE BARRIER 90 MIN. OPENING PROTECTIVE
- 1FS — 1-HOUR FIRE/SMOKE BARRIER 45 MIN. OPENING PROTECTIVE*
- 1FB — 1-HOUR FIRE BARRIER 45 MIN. OPENING PROTECTIVE*
- 1SB — 1-HOUR SMOKE BARRIER SOLID CORE WOOD DOOR
- ST — BARRIER TO LIMIT THE TRANSFER OF SMOKE
- STE — SUITE BOUNDARY FOR ADJACENT SUITES
- S# # — NON-SLEEPING SUITE
- S# # — SLEEPING SUITE
- S# # — NON-PATIENT SUITE
- HZ — HAZARDOUS AREA
- SHAFT — VERTICAL SHAFT
- EXIT OR EXIT DISCHARGE
- DENOTES DRY CHEMICAL EXTINGUISHER (BC TYPE)
- DENOTES DRY CHEMICAL EXTINGUISHER (ABC TYPE)
- DENOTES ILLUMINATED EXIT SIGN - SINGLE FACE, CEILING MOUNTED
- DENOTES ILLUMINATED EXIT SIGN - DOUBLE FACE, CEILING MOUNTED
- DENOTES FIRE-SMOKE DAMPER
- DENOTES SMOKE DAMPER
- DENOTES FIRE DAMPER

*60 MINUTE OPENING PROTECTIVE AT EXIT ENCLOSURE

GENERAL NOTES

1. BUILDING IS AN EXISTING HEALTHCARE OCCUPANCY PER CHAPTER 19 OF NFPA 101.
2. BUILDING IS EQUIPPED WITH AN AUTOMATIC SPRINKLER SYSTEM THROUGHOUT.
3. BUILDING IS EQUIPPED WITH AN AUTOMATIC FIRE ALARM SYSTEM THROUGHOUT.
4. DRAWINGS ARE FOR INFORMATION PURPOSES ONLY. THEY ARE NOT DESIGN DOCUMENTS OR INTENDED TO REFLECT AS-BUILT CONDITIONS.
5. DEVICE LOCATION IS BY OBSERVATION ONLY AND IS GENERAL IN NATURE. DEVICES THAT ARE CONCEALED OR NOT VIEWABLE USING A 6-FOOT LADDER MAY NOT BE INCLUDED.

JENSEN HUGHES
Advancing the Science of Safety
2301 West Plano Pkwy
Suite 210
Plano, TX 75075-8402
O: 469-443-7200 | F: 469-443-7201
www.jensenhughes.com

NO.	REVISION	DATE

KEY PLAN

SEAL

IT IS A VIOLATION OF STATE LAW FOR ANY PERSON, UNLESS ACTING UNDER THE DIRECTION OF A LICENSED ENGINEER, TO ALTER THIS DRAWING IN ANY WAY. IF AN ITEM IS ALTERED, THE ALTERING ENGINEER SHALL AFFIX TO THE ITEM HIS/HER SEAL AND THE NOTATION "ALTERED BY" FOLLOWED BY HIS/HER SIGNATURE AND THE DATE OF SUCH ALTERATION, AND A SPECIFIC DESCRIPTION OF THE ALTERATION.

PROJECT
JPS Patient Care Pavilion

ADDRESS
1575 South Main St.
Fort Worth, TX 76014

PROJECT NO 1MRG20017.00

DATE April 2, 2021

DESIGN	DRAWN BY	CHECKED BY
TME	VALUE	MRG

SCALE
SCALE AS NOTED

TITLE

LEVEL 4
VALUE

NUMBER
LS-005

SHEET VALUE OF 15

LEVEL 5 - SMOKE COMPARTMENTS

COMPARTMENT ID	COMPARTMENT SQ. FT.	AREA USE	MAXIMUM DISTANCE TO SMOKE BARRIER (FT)	MAXIMUM DISTANCE TO EXIT (FT)
5A	13,708	HEALTHCARE	188	142
5B	7,472	HEALTHCARE	138	125
5C	8,403	HEALTHCARE	157	163
TOTAL:	29,583			

1 - LS-006 **LEVEL 5** 3/32"=1'-0"

LIFE SAFETY LEGEND

- 2FS — 2-HOUR FIRE/SMOKE BARRIER 90 MIN. OPENING PROTECTIVE
- 2FB — 2-HOUR FIRE BARRIER 90 MIN. OPENING PROTECTIVE
- 1FS — 1-HOUR FIRE/SMOKE BARRIER 45 MIN. OPENING PROTECTIVE*
- 1FB — 1-HOUR FIRE BARRIER 45 MIN. OPENING PROTECTIVE*
- 1SB — 1-HOUR SMOKE BARRIER SOLID CORE WOOD DOOR
- ST — BARRIER TO LIMIT THE TRANSFER OF SMOKE
- STE — SUITE BOUNDARY FOR ADJACENT SUITES
- S# # — NON-SLEEPING SUITE
- S# # — SLEEPING SUITE
- S# # — NON-PATIENT SUITE
- HZ — HAZARDOUS AREA
- SHAFT — VERTICAL SHAFT
- EXIT OR EXIT DISCHARGE
- DENOTES DRY CHEMICAL EXTINGUISHER (BC TYPE)
- DENOTES DRY CHEMICAL EXTINGUISHER (ABC TYPE)
- DENOTES ILLUMINATED EXIT SIGN - SINGLE FACE, CEILING MOUNTED
- DENOTES ILLUMINATED EXIT SIGN - DOUBLE FACE, CEILING MOUNTED
- DENOTES FIRE-SMOKE DAMPER
- DENOTES SMOKE DAMPER
- DENOTES FIRE DAMPER

*60 MINUTE OPENING PROTECTIVE AT EXIT ENCLOSURE

GENERAL NOTES

1. BUILDING IS AN EXISTING HEALTHCARE OCCUPANCY PER CHAPTER 19 OF NFPA 101.
2. BUILDING IS EQUIPPED WITH AN AUTOMATIC SPRINKLER SYSTEM THROUGHOUT.
3. BUILDING IS EQUIPPED WITH AN AUTOMATIC FIRE ALARM SYSTEM THROUGHOUT.
4. DRAWINGS ARE FOR INFORMATION PURPOSES ONLY. THEY ARE NOT DESIGN DOCUMENTS OR INTENDED TO REFLECT AS-BUILT CONDITIONS.
5. DEVICE LOCATION IS BY OBSERVATION ONLY AND IS GENERAL IN NATURE. DEVICES THAT ARE CONCEALED OR NOT VIEWABLE USING A 6-FOOT LADDER MAY NOT BE INCLUDED.

JENSEN HUGHES
Advancing the Science of Safety
2301 West Plano Pkwy
Suite 210
Plano, TX 75075-8402
O: 469-443-7200 | F: 469-443-7201
www.jensenhughes.com

NO.	REVISION	DATE

KEY PLAN

SEAL

IT IS A VIOLATION OF STATE LAW FOR ANY PERSON, UNLESS ACTING UNDER THE DIRECTION OF A LICENSED ENGINEER, TO ALTER THIS DRAWING IN ANY WAY. IF AN ITEM IS ALTERED, THE ALTERING ENGINEER SHALL AFFIX TO THE ITEM HIS/HER SEAL AND THE NOTATION "ALTERED BY" FOLLOWED BY HIS/HER SIGNATURE AND THE DATE OF SUCH ALTERATION, AND A SPECIFIC DESCRIPTION OF THE ALTERATION.

PROJECT
JPS Patient Care Pavilion

ADDRESS
1575 South Main St.
Fort Worth, TX 76014

PROJECT NO 1MRG20017.00

DATE April 2, 2021

DESIGN	DRAWN BY	CHECKED BY
TME	VALUE	MRG

SCALE
SCALE AS NOTED

TITLE

LEVEL 5
VALUE

NUMBER
LS-006

SHEET VALUE OF 15

REVDATE: - FILE NAME: \\Shared\Legacy\US\EMO\Proj\1-ISEHWRT\1MRG20017.000 - JPS Fire and Life Safety (JPS)\5.0 Jet Life Safety Drawings\2.0 Main Campus\Life Safety\JPS Pavilion Life Safety.dwg LAYOUT NAME: LS-006 PLOTTED: Tuesday, March 30, 2021 - 10:41am

1 - LS-007 **LEVEL 6** 3/32"=1'-0"

LIFE SAFETY LEGEND

2FS	2-HOUR FIRE/SMOKE BARRIER 90 MIN. OPENING PROTECTIVE
2FB	2-HOUR FIRE BARRIER 90 MIN. OPENING PROTECTIVE
1FS	1-HOUR FIRE/SMOKE BARRIER 45 MIN. OPENING PROTECTIVE*
1FB	1-HOUR FIRE BARRIER 45 MIN. OPENING PROTECTIVE*
1SB	1-HOUR SMOKE BARRIER SOLID CORE WOOD DOOR
ST	BARRIER TO LIMIT THE TRANSFER OF SMOKE
STE	SUITE BOUNDARY FOR ADJACENT SUITES
S# #	NON-SLEEPING SUITE
S# #	SLEEPING SUITE
S# #	NON-PATIENT SUITE
HZ	HAZARDOUS AREA
SHAFT	VERTICAL SHAFT
	EXIT OR EXIT DISCHARGE
	DENOTES DRY CHEMICAL EXTINGUISHER (BC TYPE)
	DENOTES DRY CHEMICAL EXTINGUISHER (ABC TYPE)
	DENOTES ILLUMINATED EXIT SIGN - SINGLE FACE, CEILING MOUNTED
	DENOTES ILLUMINATED EXIT SIGN - DOUBLE FACE, CEILING MOUNTED
	DENOTES FIRE-SMOKE DAMPER
	DENOTES SMOKE DAMPER
	DENOTES FIRE DAMPER

*60 MINUTE OPENING PROTECTIVE AT EXIT ENCLOSURE

GENERAL NOTES

1. BUILDING IS AN EXISTING HEALTHCARE OCCUPANCY PER CHAPTER 19 OF NFPA 101.
2. BUILDING IS EQUIPPED WITH AN AUTOMATIC SPRINKLER SYSTEM THROUGHOUT.
3. BUILDING IS EQUIPPED WITH AN AUTOMATIC FIRE ALARM SYSTEM THROUGHOUT.
4. DRAWINGS ARE FOR INFORMATION PURPOSES ONLY. THEY ARE NOT DESIGN DOCUMENTS OR INTENDED TO REFLECT AS-BUILT CONDITIONS.
5. DEVICE LOCATION IS BY OBSERVATION ONLY AND IS GENERAL IN NATURE. DEVICES THAT ARE CONCEALED OR NOT VIEWABLE USING A 6-FOOT LADDER MAY NOT BE INCLUDED.

JENSEN HUGHES
Advancing the Science of Safety
2301 West Plano Pkwy
Suite 210
Plano, TX 75075-8402
O: 469-443-7200 | F: 469-443-7201
www.jensenhughes.com

NO.	REVISION	DATE

KEY PLAN

NORTH

SEAL

IT IS A VIOLATION OF STATE LAW FOR ANY PERSON, UNLESS ACTING UNDER THE DIRECTION OF A LICENSED ENGINEER, TO ALTER THIS DRAWING IN ANY WAY. IF AN ITEM IS ALTERED, THE ALTERING ENGINEER SHALL AFFIX TO THE ITEM HIS/HER SEAL AND THE NOTATION "ALTERED BY" FOLLOWED BY HIS/HER SIGNATURE AND THE DATE OF SUCH ALTERATION, AND A SPECIFIC DESCRIPTION OF THE ALTERATION.

PROJECT
JPS Patient Care Pavilion

ADDRESS
1575 South Main St.
Fort Worth, TX 76014

PROJECT NO
1MRG20017.00

DATE
April 2, 2021

DESIGN	DRAWN BY	CHECKED BY
TME	VALUE	MRG

SCALE
SCALE AS NOTED

TITLE

LEVEL 6
VALUE

NUMBER
LS-007

SHEET
VALUE OF 15